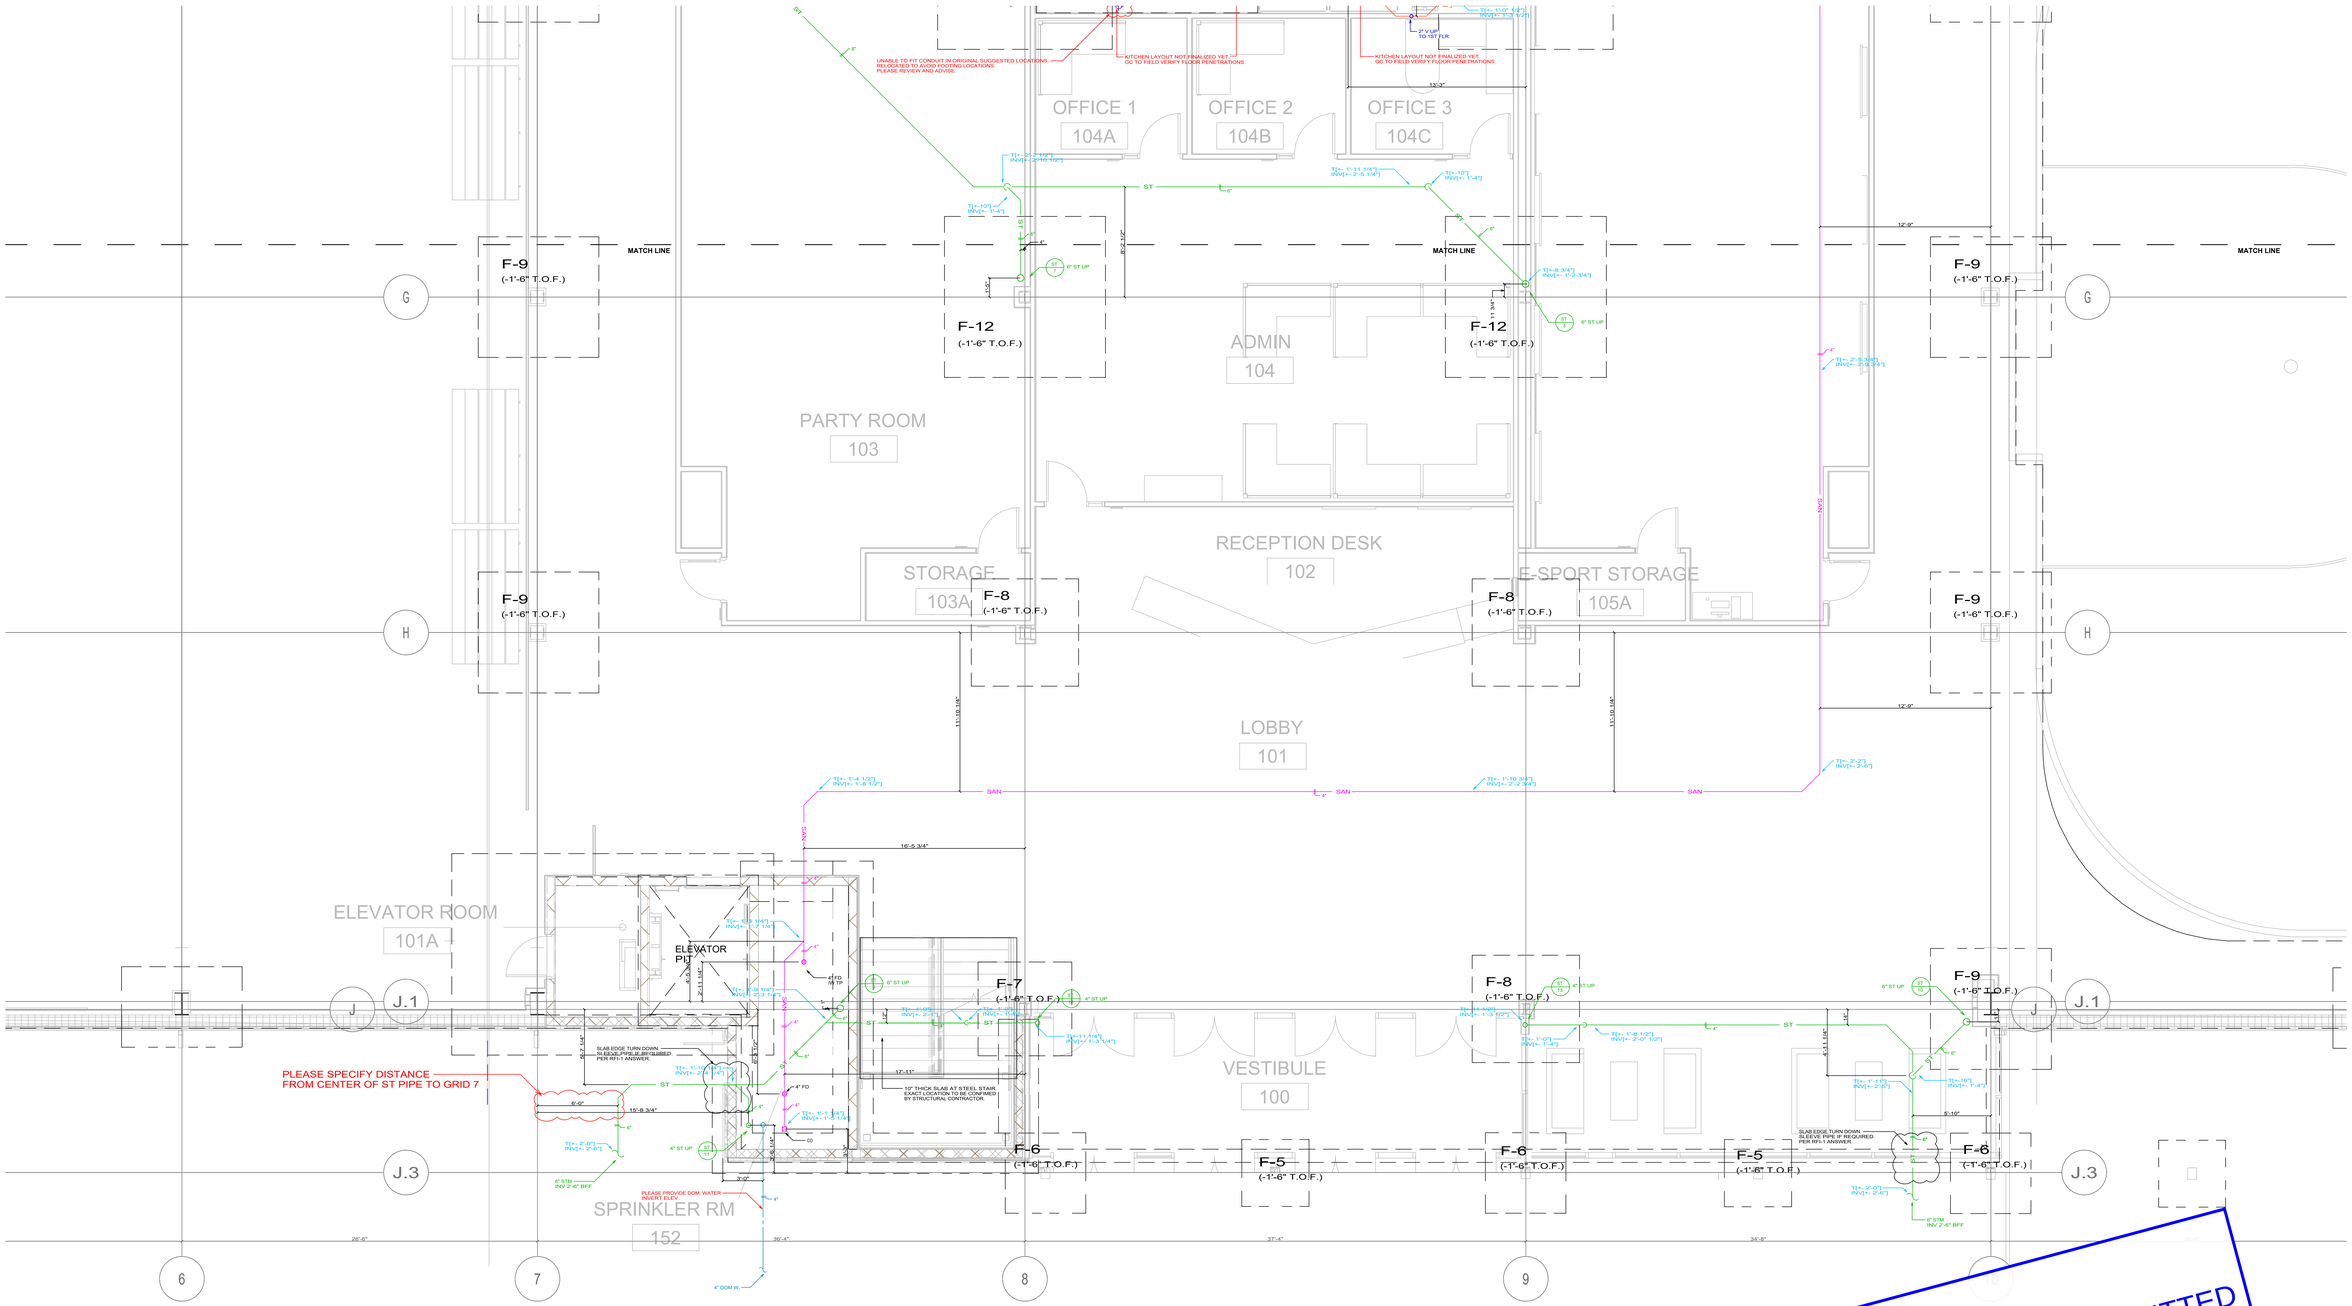

THIS SAMPLE IS A DRAWING SUBMITTED TO THE CONTRACTOR/DESIGN TEAM FOR REVIEW OF REMAINING CLASHES, SHOWN IN RED.

FOR SUBMISSION-ENGINEER REVIEW

All submission drawings are to be approved by the Architect and Engineer prior to any fabrication and installation. These drawings illustrate our interpretation of the contract drawings. “No exceptions taken”, “Appears to comply”, “Reviewed" or other indistinct stamps will be interpreted as an approval and our customer will proceed with fabrication and installation.

KEY PLAN

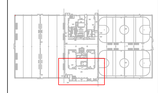

TRADE	DATE	REVISIONS	NO.	DATE	AUTHORIZED SIGNATURE	AUTHORIZED PERSONNEL (PRINT)	COMPANY
MECHANICAL							
SHEET METAL							
PLUMBING							
ELECTRICAL							
SPRINKLER							
GEN. CONTRACTOR							
ARCHITECT							
ENGINEER							

CONTRACTORS

THIS DRAWING IS PRODUCED BY:

SHOPDRAWINGS.COM
10315 CANNON FORGE LANE
HAGERSTOWN MD 21742

(301) 926-6000
WWW.SHOPDRAWINGS.COM

P101-3

PROJECT:

HAGERSTOWN FIELD HOUSE
290 Eastern Memorial Blvd
Hagerstown, MD 21740

UNDERGROUND PLUMBING

Scale: 1/4" = 1'-0"

March 14, 2024